No: 26-076

Dauphin County Subdivision/Land Development Review Report

Municipality	City of Harrisburg	Surveyor	Terra Viz, Inc.	Engineer	LIVIC Civil, LLC
Plat Title	1257 & 1259 Walnut Street P/F Land Development and Lot Consolidation Plan				
Zoning District	Residential Medium Density District (RM)	Proposed Land Use	Multi Family Residential		

Plat Status:	___ Preliminary	**Plat Type:**	___ Subdivision	**Regulations:**	___ County
	___ Final		___ Land Development		x Municipal
	X P/F		X Combined		x Zoning
	___ Minor				x S&LD

# of Lots	# of New Lots	# of New D.U.s	Acreage Subdivided/Developed	Total Acreage
2	1	6	.07	.08

Date Received	7-27-2026	Staff Review	7-31-2026	Official County Review	7-31-2026
Reviewed by	GD	Checked by		Parcel No.	07-071-015

Project Description: To construct an innovative, multi story residential structure

- ***When applicable, streets, sewer, water, storm drainage, and other infrastructure elements to be verified as adequate by municipal staff/engineer. Any improvement guarantees shall be posted prior to final plat approval.***
- ***Registered PA Land Surveyor is required to certify all lot/tract boundary descriptions.***
- ***When applicable, zoning compliance to be verified by Municipal Zoning Officer.***
- ***Appropriate sewage module component should be processed prior to final plat approval.***
- ***Final plats must be recorded within 90 days of approval.***

Review comment with cited ordinance provisions are based on municipal regulations on file with the County Planning Commission.

1. The Dauphin County Planning Commission staff has reviewed this plan at the request of the Harrisburg City Planning Department, as a requirement of State Code. The review is based on the current Subdivision & Land Development Ordinance, Chapter 7-5. According to the Pennsylvania Municipal Planning Code definition, the proposed development does qualify as a Subdivision/Land Development and was reviewed against those City requirements. The review recognizes the type of development being proposed but given no other options, the review was performed against the current ordinance. In an effort to reduce the duplication of producing the review comments, the staff has highlighted, on the City's own checklist, the development requirements missing and most pertinent to this review and attached that checklist to this cover page.
2. In addition, provided are some general observations:
    a. The submitted plan appears to propose the consolidation of two existing parcels into a single lot. The plan also indicates a permeable pavement area intended to serve both as a sidewalk and as a stormwater management feature. It is assumed that this improvement is being provided to satisfy the applicable requirements for both functions. However, the permeable pavement area appears to be located within the Walnut Street right-of-way. It is unclear whether this improvement is intended to become the City's responsibility for long-term maintenance and upkeep. The plan does not identify any easements, maintenance agreements, or notes that address ownership and long-term maintenance responsibilities for this feature. Clarification should be provided.
    b. The property is identified as being located within the Summit Hill ACOD. No building elevations were provided with the submission. Care should be taken to ensure that the proposed development complies with all applicable ACOD requirements, including any architectural, design, or historic preservation standards associated with the district. Submission of building elevations may be necessary to verify compliance.

City of Harrisburg
Subdivision and/or Land Development Checklist

Please use this checklist as a guide for submitting a Subdivision and/or Land Development Plan application. The content of this checklist is drawn from Chapter 7-501 of the Subdivision and Land Development Ordinance and will be used by City and County Planning Staff to evaluate your plans; however, it should not be used as a replacement for, or in lieu of the SALD Code. Applicants are encouraged to refer to the Code when preparing plans.

DRAFTING STANDARDS

	Provided	Not Provided	Waiver Requested	Ordinance	Standards
1	X	☐	☐	505.3(d)	Twenty-three (23) total copies of the plans shall be submitted with the application. **Four (4)** sets shall measure **24" x 36"** (required by Dauphin County Recorder of Deeds), and nineteen **(19)** sets shall measure **11" by 17" or half sheet size.**
2	X	☐	☐	505.3(b)	Dimensions shall be in feet and decimals; bearings shall be in degrees, minutes and seconds. Lot line descriptions shall read in a clockwise direction.

All plans should include a cover sheet following the guidelines listed below.

COVER SHEET

	Provided	Not Provided	Waiver Requested	Ordinance	Standards
3	X	☐	☐	505.4(1)	Title of the project
4	X	☐	☐	505.1(A&B) 505.4(3) 505.10(1)	Name, address, phone number of the owner of the tract, the developer/ subdivider, and the firm that prepared the plans
5	X	☐	☐	505.4(4) 505.10(1)	File Number assigned by the firm, the plan date, and the date(s) of all revisions.
6	X	☐	☐	505.4(7) 505.10(1)	The total acreage of the tract or project
7	X	☐	☐	505.4(8) 505.10(1)	The district, setbacks, lot size, and/or density requirements of the City's Zoning Ordinance
8	X	☐	☐	505.1(c)	A location map, relating the project area to its location in the city
9	X	☐	☐	505.6(12) 505.10(8)(l)	A statement on the Plan indicating that all zoning approvals have been obtained
10	X	☐	☐	505.6(13) 505.10(8)(m)	A statement on the Plan indicating any existing or proposed waivers have been granted by City Council
11	X	☐	☐	505.10(8)(o)	A source of title to the land, as shown by book of the Dauphin County Recorder of Deeds (for Final Plans)
12	X	☐	☐	505.7(e) 505.10(9) (f)(i)	Certification of the engineer, surveyor or landscape architect, to the effect that the plans are accurate (See Appendix No. 1 in the SD/LD Code)
13	X	☐	☐	505.7(e) 505.10(9) (f)(iii)	Signature block as it will appear on the Final Plan (See Appendices No. 2 A to 2-C and No. 3 A to 3 B)

14	X	☐	☐	505.10(9)(f)(iv)	Notation space to accommodate the Dauphin County Recorder of Deeds information (including Plan Book, Volume and Page)

The preferred layout of the cover sheet is represented in Figure 1 (below):

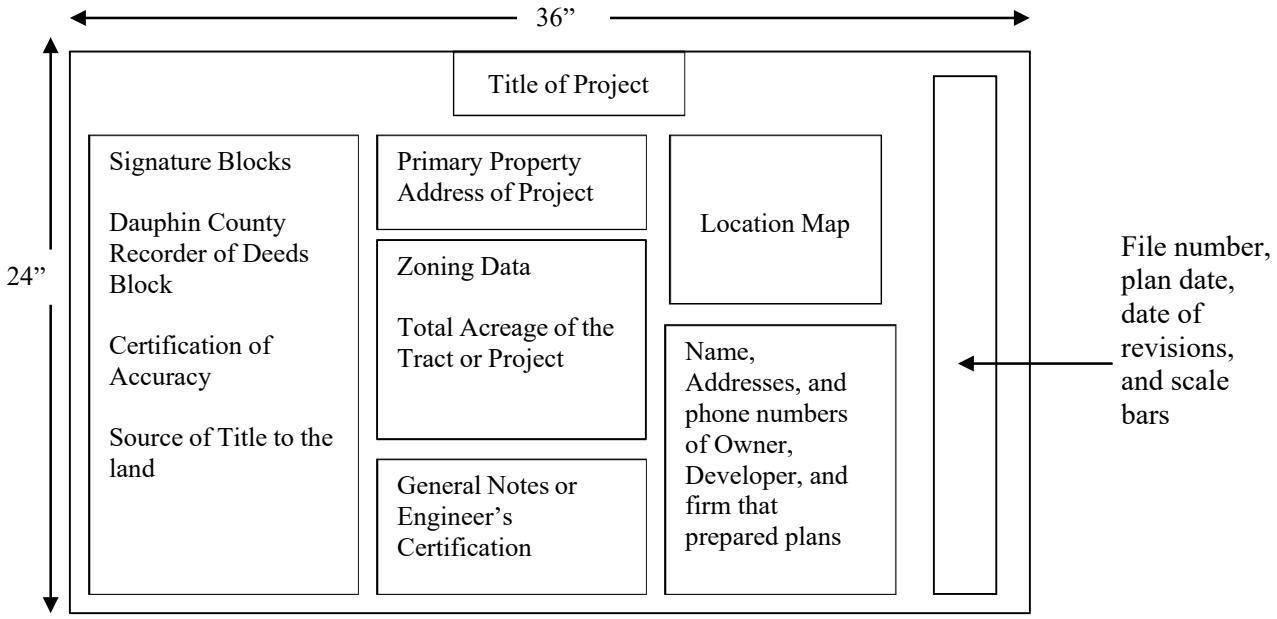


Figure 1

BASIC PLAN REQUIREMENTS

	Provided	Not Provided	Waiver Requested	Ordinance	Standards
15	X	☐	☐	505.9(1) 505.10 (11)(A)	Check or money order made out to “City Treasurer” in an amount specified on Subdivision/Land Development Fee Schedule
16	X	☐	☐	505.9(2) 505.10 (11)(B)	Check made out to Dauphin County Planning Commission in an amount specified on Subdivision/Land Development Fee Schedule
17	X	X	☐	505.4(2)	Location of any municipal boundary line (if applicable)
18	X	☐	☐	505.4(5)	A north arrow, a graphic scale, and a written scale
19	X	☐	☐	505.4(6)	The entire existing tract boundary with bearings and distances
20	X	☐	☐	505.4(7)	The total acreage of each tract involved with the project
21	X	☐	☐	505.4(9)	The location of existing lot line markers along the perimeter of the existing tract
22	X	☐	☐	505.4(10)	A location map, relating the project site to at least 2 intersections of street centerlines
23	X	☐	☐	505.4(11)	Property address(es) as assigned by the City’s Registrar of Real Estate
24	X	☐	☐	505.5(1) 505.10(3)	Existing contours, at an interval of 2 feet for land with an average slope of four percent (4%) or less and at a minimum vertical interval of 5 feet for more steeply sloping land
25	X	☐	☐	505.5(2) 505.10(4)	Names of all adjacent landowners and the names and plan book numbers of all recorded plans for adjacent projects
26	☐	X	☐	505.10(5)	Location of historic structures, wetlands, unbuildable portions of the site, or other significant features

27	X	☐	☐	505.6(1) 505.10(8)(A)	Layout of streets, alleys, sidewalks, including cartway and rights-of-way widths. For Final Plans this shall include distances and bearings, with curve segments comprised of radius, tangent, arc, and chord
28	X	☐	☐	7-505.6(2) 505.10(8)(B)	Lot lines, with accurate bearings and distances and lot areas for all parcels
29	☐	X	☐	505.6(3) 505.10(8)(C)	Block and lot numbers in consecutive order
30	X	☐	☐	505.6(5) 505.10(8)(E)	Total number of lots, units of occupancy, density, and proposed land use
31	X	☐	☐	505.6(6) 505.10(8)(F)	Easements and rights-of-way
32	X	☐	☐	505.6(7) 505.10(8)(G)	Building setback lines with distances from front, rear, and side yard property lines
33	X	☐	☐	505.6(8) 505.10(8)(H)	Identification of buildings to be demolished
34	☐	X	☐	505.6(9) 505.10(8)(I)	Typical cross section of each street ***proposed*** or to be ***improved*** as part of the application. Cross section shall include entire right-of-way width
35	X	☐	☐	505.6(14) 505.10(8)(N)	Street names
36	X	☐	☐	505.10(8)(P)	Location and material of all permanent monuments and lot line markers, noting that all monuments and markers are set, or indicating when they will be set (for Final Plans)
37	☐	X	☐	505.10(8)(R)	Identification of any lands to be dedicated *
38	X	☐	☐	505.7(c)(4) 505.10(9)(D)(iv) 507.7(1)(c)	Provide a Landscaping Plan

* See note regarding permeable paver

The following when located **within fifty feet of the site:**

	Provided	Not Provided	Waiver Requested	Ordinance	Standards
39	X	☐	☐	505.5(3)(A) 505.10(6)(A)	Approximate location and name of existing rights-of-way and cartways for streets, access drives, and service streets
40	X	☐	☐	505.5(3)(B) 505.10(6)(B)	Sanitary sewer mains
41	X	☐	☐	505.5(3)(B) 505.10(6)(B)	Water supply mains
42	X	☐	☐	505.5(3)(B) 505.10(6)(B)	Fire hydrants
43	☐	X	☐	505.5(3)(D) 505.10(6)(C)	Storm water management facilities which effect storm water runoff on the site. Include the size, capacity, and condition of existing stormwater management system

Pavers to serve as storm water controls?

The following when located **within the site:**

	Provided	Not Provided	Waiver Requested	Ordinance	Standards
44	X	☐	☐	505.5(4)(A) 505.10(7)(A)	The location, name, and dimensions of existing rights-of-way and cartways for streets, access drives, driveways, and service streets
45	X	☐	☐	505.5(4)(A) 505.10(7)(B)	Sanitary sewer mains
46	X	☐	☐	505.5(4)(A)	Water supply mains

				505.10(7)(B)	
47	☐	☒	☐	505.5(4)(A) 505.10(7)(B)	Fire hydrants
48	☒	☐	☐	505.5(4)(A) 505.10(7)(B)	Buildings
49	☒	☐	☐	505.5(4)(D) 505.10(7)(B)	Stormwater management facilities
50	☐	☒	☐	505.5(4)(C) 505.10(7)(C)	The location of existing rights-of-way for electric, gas, and oil transmission lines and railroads
51	☐	☒	☐	505.5(4)(D) 505.10(7)(D)	The size, capacity, and condition of the existing stormwater management system

Certificates and Notifications

	Provided	Not Provided	Waiver Requested	Ordinance	Standards
52	☐	☒	☐	505.7(b) 505.10(9)(B)	Correspondence from the owner or lessee of any electric transmission lines, gas pipelines, or petroleum projects transmission lines, located within the tract, stating any conditions on the use of the land and the minimum building setback and/or right-of-way line
53	☐	☒	☐	505.7(d) 505.10(9)(E)	Traffic Impact Study, if required by City Engineer
54	☐	☒	☐	505.10(9)(A)	Notification of approval from PA D.E.P. for any stormwater management facilities that effect an existing watercourse or have an upland drainage area greater than one-half mile; or that no approval is required
55	☐	☒	☐	505.10(9)(J)	For plans which require access to a State Highway, the inclusion of the following plan note: "A Highway Occupancy Permit is required pursuant to Section 420 of the Act of June 1, 1945 (P.L. 1242, No. 428), known as the "State Highway Law", before driveway access toa State Highway is permitted. Access to the State highway shall only be as authorized by a Highway Occupancy Permit, and City Council's/Planning Commission's approvals of this plan implies that such permit can be acquired."

Natural Features Preservation

	Provided	Not Provided	Waiver Requested	Ordinance	Standards
56	☐	☒	☐	507.7(1)(A)	Trees with a caliper of six inches (6") or more, measures at a height of 4-1/2 feet above grade, are to be retained, if not within proposed cartway, or sidewalk portion of street right-of-way, or within 15 feet of a proposed building
57	☐	☒	☐	507.7(1)(B)	Where existing trees are removed along the street right-of-way, supplemental plantings required
58	☐	☒	☐	507.7(2)(A)	Maintenance easement provided along all stream, river banks, and lake edges. Minimum width of easement to be 25 feet
59	☐	☒	☐	507.7(2)(B)	Water frontage to be preserved as open space whenever possible
60	☐	☒	☐	507.7(2)(C)	Access to be provided to the water and to maintenance easement area. Width of access points to be minimum of 50 feet
61	☒	☐	☐	507.7(3)	Existing terrain to be preserved when possible. Cut and fill to be kept to a minimum

ADDITIONAL SUBDIVISION AND LAND DEVELOPMENT REQUIREMENTS

	Provided	Not Provided	Waiver Requested	Ordinance	Standards
62	☐	☒	☐	505.7(f)	For Preliminary Plan calling for installation of improvements beyond two years, a schedule of the timing of the improvements
63	☒	☐	☐	505.10(9)(A)	Notification from PA D.E.P. that either approval of the Sewer Facility Plan Revision or Supplement has been granted or that such approval is not required (Plan Revision Modular for Land Development)
64	☒	☐	☐	505.10(8)(D)	For Land Development Plans, the location and configuration of proposed buildings, parkingcompounds, streets, access drives, driveways, and all other significant planned facilities
65	☒	☐	☐	505.10(8)(Q)	For Land Development Plans, a grading plan, whichshall include finished grades and ground floor elevations(may be provided on separate sheets, need not be recorded)
66	☐	☒	☐	505.10(9)(H)	Approval from the City Solicitor of the Improvement Construction Guarantee

Land Development Plans ***must include*** drawings of the proposed development showing:

	Provided	Not Provided	Waiver Requested	Ordinance	Standards
67	☒	☐	☐	505.7(c)(4) 505.10(9)(D)(iv) 507.7(1)(c)	Landscape Plan showing treatment of private and common open space, the perimeter of the site, and elevation drawings highlighting the landscaping
68	☒	☐	☐	505.7(c)(1) 505.10(9)(D)(i)	Elevation of all visible sides, including façade materials
69	☒	☐	☐	505.7(c)(2) 505.10(9)(D)(ii)	Location and floor area of all existing and proposed buildings, structures, and other improvements, including height, types of units, and uses
70	☐	☒	☐	505.7(c)(3) 505.10(9)(D)(iii)	Details of significant architectural features Not part of DCPC submittal (see comment)
71	☐	☒	☐	505.7(c)(5) 505.10(9)(D)(v)	Vehicular and Pedestrian Circulation Plan, including parking, service areas, waiting areas, and major access points Assume waiver for parking granted
72	☐	☒	☐	505.7(c)(6) 505.10(9)(D)(vi)	Lighting, screening, drainage, and dimensions of all off-street parking areas

Design of the Utility Plan, which shall include the size, material, and vertical and horizontal locations of sanitary sewer, storm sewer, and water mains:

	Provided	Not Provided	Waiver Requested	Ordinance	Standards
73	☒	☐	☐	505.10(8)(K)(i)	Include all calculations, assumptions, criteria, and references used in the design of stormwater management facilities, the establishment of existing facilities capacities, and the pre- and post-development discharge
74	☒	☐	☐	505.10(8)(K)(ii)	All plans and profiles of the proposed stormwater management facilities
75	☐	☒	☐	505.10(8)	For all basins, a plotting or tabulation of the storage

				(K)(iii)	volumes and discharge curves with corresponding water surface elevations, inflow hydrographs, and outflow hydrographs See previous note regarding stormater and pavers
76	X	☐	☐	505.10(8) (K)(iv)	Guidelines for lot grading within the subdivision, identifying the direction of stormwater runoff within each lot, and the areas where runoff will be concentrated (show using topographic data)
77	☐	X	☐	505.10(8) (K)(v)	Soil characteristics report and information on erosion and sediment control from the Dauphin County Soil and Water Conservation District

Block Layouts

	Provided	Not Provided	Waiver Requested	Ordinance	Standards
78	☐	X	☐	507.4(b)	Blocks shall not exceed 750 feet and must be compatible with the City's existing grid system
79	☐	X	☐	507.4(c)	Residential blocks should be of sufficient depth to accommodate 2 tiers of lots

Lot Configurations

	Provided	Not Provided	Waiver Requested	Ordinance	Standards
80	☐	X	☐	507.5(a)(1)	Size, depth, width, and orientation of lots shall conform to City zoning requirements
81	X	☐	☐	507.5(a)(2)	Side lot lines should be at right angles to straight street lines or radial to curved street lines, if practical
82	☐	X	☐	507.5(a)(3)	Where feasible lot lines should follow municipal boundaries rather than cross them
83	☐	X	☐	507.5(a)(4)	Remnants of land shall be incorporated into existing or proposed lots
84	X	☐	☐	507.5(b)(1)	All lots shall abut a street, existing or proposed
85	X	☐	☐	507.5(b)(2)	Double or reverse frontage lots shall be avoided
86	☐	X	☐	507.5(d)	Non-residential lots shall provide adequate space for yards, off-street loading and unloading, and parking

Building Design Guidelines

Historic District Compliance?

	Provided	Not Provided	Waiver Requested	Ordinance	Standards
87	X	☐	☐	507.6(1)	Compatibility with existing structures
88	X	☐	☐	507.6(2)	Design incorporates architectural details found on adjacent buildings
89	X	☐	☐	507.6(3)	Building materials reflect surrounding development

STREETS, ACCESS STREETS, AND DRIVES – ADDITIONAL REQUIREMENTS

	Provided	Not Provided	Waiver Requested	Ordinance	Standards
90	☐	X	☐	505.6(9) 505.10(I)	Typical cross section of each street proposed or to be improved as part of the application. Cross section shall include entire right-of-way width
91	☐	X	☐	505.6(10)	Street centerline profile for each proposed street shown on the plan
92	☐	X	☐	505.6(1) 505.7(a)	Sketch of future street system, where Preliminary Plan covers only a part of the entire landholdings
93	☐	X	☐	505.10(9)(C)	Notice from postmaster that the proposed street names

					are acceptable
94	☐	X	☐	505.10(9)(I)	Maintenance agreement for street which is not to be offered for dedication
95	☐	X	☐	507.2(a)(5)	Street arrangement provides for continuation of streets in adjoining areas
96	☐	X	☐	507.2(a)(5)	Provide for proper projection of streets where adjoining areas are not subdivided
97	☐	X	☐	507.2(a)5)	New streets carried to the boundaries of the tract to be subdivided
98	☐	X	☐	507.2(a)(7)	Residential alleys are discouraged, unless site design calls for rear access parking; 22-foot minimum width if used
99	☐	X	☐	507.2(a)(7)	Adequate alleys or off-street loading and unloading required in commercial or industrial areas
100	☐	X	☐	507.2 (c)(1)	Cartways to be minimum of 11-foot travel lanes
101	☐	X	☐	507.2(c)(3)	Minimum street rights-of-way and cartway widths will be: STREET TYPE — R.O.W. WIDTH — CARTWAY **Arterial — determined by governing body after consultation with PennDOT** Collector — 60 feet — 22 feet Local — 50 feet — 22 feet Alley/service drive — 30 feet — 22 feet
102	☐	X	☐	507.2(d)(3) 507.2(d)(5)	Permanent dead-end streets not longer than 500 feet and provided with a cul-de-sac, having minimum outside road diameter of 80 feet
103	☐	X	☐	507.2(e)(3)	Tangents between curves according to Engineering specifications
104	☐	X	☐	507.2(f)(1)	Centerlines of streets intersect as nearly to 90 degrees as possible, but not less than 75 degrees, or more than 105 degrees
105	☐	X	☐	507.2(f)(2)	Intersections involving the junction of more than two streets are prohibited
106	☐	X	☐	507.2(f)(3)	Street jogs with centerline off-sets of less than 125 feet avoided
107	☐	X	☐	507.2(f)(5)	Intersections with major streets shall be located not less than 800 feet apart
108	☐	X	☐	507.2(h)	Street grades in accordance with Engineering specifications
109	☐	X	☐	505.6(14)	New street names shall not duplicate existing names
110	☐	X	☐	507.2(j)(1)	Direct access from residential lots to arterials shall be avoided
111	☐	X	☐	507.2(j)(2)	Driveways on corner lots shall be located 40 feet from the point of intersection of the nearest street right-of-way
112	☐	X	☐	507.2(j)(3) (A)	Access roads/driveways shall be: no less than 24 feet in width for multi-family residential, and all non-residential development
113	☐	X	☐	507.2(j)(3) (B)	Access roads/driveways shall be no less than 10 feet for single family residential subdivisions, and no greater than 20 feet at the street line
114	☐	X	☐	507.2(j)(5) (A&B)	Grade on access road/driveway shall not exceed 8% on arterial and 10% on collector or minor street

EASEMENT REQUIREMENTS

	Provided	Not Provided	Waiver Requested	Ordinance	Standards
115	☐	X	☐	507.3(a)(1)	Minimum width shall be twenty (20) feet
116	☐	X	☐	507.3(a)(2)	When possible, easements shall be centered on the side

					or rear lot lines or along the front lot lines
117	☐	☒	☐	507.3(b)	If subdivision is traversed by a water course or drainageway, an easement shall be provided conforming with the line of such water course or drainageway

CONDOMINIUM PROJECT REQUIREMENTS

	Provided	Not Provided	Waiver Requested	Ordinance	Standards
118	☐	☒	☐	505.8(4)	Floor plans for all buildings
119	☐	☒	☐	505.8(3)	Statement of proposed use for each unit and restrictions on use, if any
120	☐	☒	☐	505.8(2)	Description of common elements, with allocation of the proportionate undivided interest expressed as a percentage assigned to each unit
121	☐	☒	☐	505.8(1)	Statement of intent to submit the property to the provisions of the Unit Property Act, Act 117 of 1963, as amended (Preliminary Plan)
122	☐	☒	☐	505.10(10)	Declaration, Declaration Plan and Code of Regulations required by the Unit Property Act, Act 117 of 1963 as amended (Final Plan - may be provided on a separate sheet)

PRELIMINARY/FINAL LAND DEVELOPMENT AND LOT CONSOLIDATION PLAN

FOR

1257-1259 WALNUT STREET

CITY OF HARRISBURG, DAUPHIN COUNTY, PENNSYLVANIA


JUNE 1, 2026

PENNSYLVANIA ONE CALL

1. LIVIC CIVIL HAS REQUESTED LINE AND UTILITY INFORMATION FROM THE PA ONE CALL SYSTEM (POCS)
2. POCS SERIAL NUMBER: 20253382230
   DATE: DECEMBER 4, 2025
3. THE FOLLOWING FACILITY OWNERS HAVE INDICATED THROUGH POCS THAT THEY HAVE FACILITIES IN THE PROJECT AREA:

UTILITY: CABLE PROTECTION SERVICES INC ADDRESS: P.O. BOX 4816 MIDLOTHIAN, VA 23112 CONTACT: DEBBIE KING EMAIL: debbie_king@cableps.com	UTILITY: HARRISBURG CITY ADDRESS: 1002 N 7TH STREET HARRISBURG, PA 17104 CONTACT: VERONICA LEFEVER EMAIL: valefever@harrisburgpa.gov
UTILITY: CAPITAL REGION WATER ADDRESS: 3003 N FRONT STREET HARRISBURG, PA 17110 CONTACT: THOMAS YORK EMAIL: thomas.york@capitalregionwater.com	UTILITY: PPL ELECTRIC UTILITIES CORPORATION ADDRESS: 437 BLUE CHURCH ROAD PAXINOS, PA 17860 CONTACT: DOUG HAUPT EMAIL: dlhaupt@pplweb.com
UTILITY: VERIZON PENNSYLVANIA LLC ADDRESS: CONTACT: OFFICE PERSONNEL EMAIL: 1Call-Verizon-PADE@verizon.com	UTILITY: UGI UTILITIES INC ADDRESS: 1301 AIP DRIVE MIDDLETOWN, PA 17057-5987 CONTACT: GEOFFREY FERGUSON EMAIL: gferguson@ugi.com

4. BEFORE YOU DIG ANYWHERE IN PENNSYLVANIA CALL 1-800-242-1776. PA ACT 287 OF 1974, AS AMENDED, REQUIRES THREE (3) WORKING DAYS NOTICE TO UTILITIES BEFORE YOU EXCAVATE, DRILL OR BLAST.

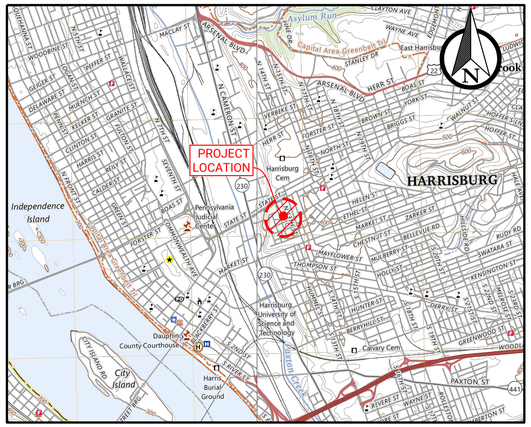

PROJECT LOCATION MAP

HARRISBURG EAST, PA USGS QUAD
HARRISBURG WEST, PA USGS QUAD
SCALE: AS SHOWN

2,000 0 2,000 4,000 FT

HORIZONTAL SCALE: 1 INCH = 2,000 FEET

GENERAL NOTES

1. APPLICANT/EQUITABLE OWNER:
   BIG US WORKBASE TRAINING, INC.
   ATTN: ARTHUR JEFFERSON
   1952 MANADA STREET
   HARRISBURG, PA 17104
   PHONE: 717.379.3481
2. LANDOWNER:
   - HARRISBURG REDEVELOPMENT AUTHORITY
   10 N. SECOND STREET, UNIT 405
   HARRISBURG, PA 17104
   PHONE: 717.255.6431
3. PROJECT LOCATION:
   1257-1259 WALNUT STREET, HARRISBURG, PA 17103
   CITY OF HARRISBURG, DAUPHIN COUNTY
   LOCATED ALONG THE SOUTHERN SIDE OF WALNUT STREET, GO WEST APPROXIMATELY 250 FEET FROM THE INTERSECTION OF NORTH 13TH STREET AND WALNUT STREET.
4. PROJECT NARRATIVE:
   BIG US WORKBASE TRAINING, INC. IS PROPOSING TO CONSTRUCT A 1,707 SQUARE FOOT MULTI-STORY RESIDENTIAL BUILDING. THE PROJECT WILL INCLUDE CONSTRUCTION OF SIDEWALK TO ACCESS THE BUILDING, ALONG WITH STORMWATER MANAGEMENT FACILITIES AND OTHER SITE FEATURES. ALSO, AS A PART OF THIS PROJECT, A LOT CONSOLIDATION OF PARCELS 09-009-011-000-0000 AND 09-009-012-000-0000 IS BEING PROPOSED.
5. SOURCE OF TITLE:
   1257 WALNUT STREET
   DEED BOOK: 5634, PAGE: 317
   PARCEL No. 09-009-011-000-0000
   1259 WALNUT STREET
   DEED BOOK: 5634, PG: 317
   PARCEL No. 09-009-012-000-0000
6. NO EXISTING WETLANDS HAVE BEEN IDENTIFIED BY THE NATIONAL WETLANDS INVENTORY WEBSITE OR BY FIELD OBSERVATION.
7. A PennDOT HIGHWAY OCCUPANCY PERMIT IS NOT REQUIRED PURSUANT TO SECTION 420 OF THE ACT OF JUNE 1, 1945 (P.L. 1242 NO. 428), KNOWN AS THE "STATE HIGHWAY LAW", BEFORE DRIVEWAY ACCESS TO A STATE HIGHWAY IS PERMITTED.
8. ACCORDING TO THE FEDERAL EMERGENCY MANAGEMENT AGENCY'S FLOOD INSURANCE RATE MAP (42043C0338D), THE PROJECT SITE IS NOT LOCATED WITHIN THE 100-YR FLOODPLAIN.
9. THE PROJECT WILL BE SERVED BY PUBLIC SANITARY SEWER AND WATER.
10. LIMIT OF DISTURBANCE: 0.08 ACRES

ZONING REGULATIONS

ZONING DISTRICT: RESIDENTIAL MEDIUM DENSITY (RM)
- PERMITTED USE: MULTI-FAMILY DWELLING - PER SPECIAL EXCEPTION

LOT REQUIREMENTS	REQUIRED	PROPOSED
MAX IMPERVIOUS LOT COVERAGE	85%	77%
MAX BUILDING HEIGHT	45 FT	<45 FT
MINIMUM LOT AREA	1,500 S.F.	3,214 S.F.
YARD SETBACKS		
FRONT BLOCK SETBACK, MIN. OF 5'	CONFORM TO EXISTING	0'
SIDE (EACH)	4 FT	5 FT MIN.
REAR	10 FT	<10 FT
PARKING REQUIREMENTS		
RESIDENTIAL: 1 SPACE / RESIDENTIAL UNIT	-	GRANTED RELIEF

PRELIMINARY/FINAL PLAN SIGNATURE BLOCK

REVIEWED BY THE DAUPHIN COUNTY PLANNING COMMISSION THIS ____DAY OF _____, 20_____.

_____ CHAIRMAN

_____ SECRETARY

REVIEWED BY THE CITY OF HARRISBURG ENGINEER THIS ____DAY OF _____, 20_____.

_____ CITY ENGINEER

RECOMMENDED FOR APPROVAL BY THE PLANNING COMMISSION OF THE CITY OF HARRISBURG THIS ___DAY OF _____, 20_____.

_____ EXECUTIVE SECRETARY

RECORDED IN THE OFFICE FOR RECORDING OF DEEDS, IN AND FOR DAUPHIN COUNTY, PENNSYLVANIA
INSTRUMENT NO. _____
DATE _____ 20_____.

_____ RECORDER

THIS PLAN APPROVED BY THE COUNCIL OF THE CITY OF HARRISBURG THIS ____DAY OF _____, 20_____.

_____ MAYOR

_____ PRESIDENT OF CITY COUNCIL

_____ CITY CLERK

ZONING DECISIONS

7-305.7: SPECIAL EXCEPTION GRANTED TO ESTABLISH MULTI-FAMILY DWELLING IN THE RM DISTRICT.
7-327.8: SPECIAL EXCEPTION FOR RELIEF FROM OFF-STREET PARKING.
7-307.3: VARIANCE FOR RELIEF OF DENSITY REQUIREMENTS.
7-307.3: VARIANCE FOR RELIEF OF ALLOWABLE BUILDING WIDTHS.

MODIFICATION REQUEST

9-903.3 B: MODIFICATION OF WATER QUALITY DUE TO POOR INFILTRATION RATES AND SITE CONSTRAINTS.

SURVEY CERTIFICATE

I HEREBY CERTIFY THAT TO THE BEST OF MY KNOWLEDGE, THE BOUNDARY AND TOPOGRAPHICAL SURVEY DESCRIBED HEREON IS CORRECT AND ACCURATE TO THE BEST OF MY KNOWLEDGE, AND HAS BEEN PREPARED TO THE ACCURACY REQUIRED BY THE GOVERNING ORDINANCES OF CITY OF HARRISBURG, LOCATED IN DAUPHIN COUNTY, PENNSYLVANIA.

TERRAVIZ GEOSPATIAL
212 S. FRONT STREET
WORMLEYSBURG, PA 17043

_____ SURVEYOR DATE

CERTIFICATE OF OWNERSHIP AND ACKNOWLEDGMENT OF PLAN (CORPORATE)

COMMONWEALTH OF PENNSYLVANIA

COUNTY OF _____:

ON THIS, THE _____DAY OF _____, 20_____, BEFORE ME, A NOTARY PUBLIC, IN AND FOR THE COMMONWEALTH AND COUNTY AFORESAID, THE UNDERSIGNED OFFICER, PERSONALLY APPEARED _____, KNOWN TO ME (OR SATISFACTORILY PROVEN), WHO ACKNOWLEDGED HIMSELF TO BE THE _____ OF _____ AND THAT HE AS SUCH _____, BEING AUTHORIZED TO DO SO, ACKNOWLEDGE THE SAME TO BE THEIR ACT AND PLAN, AND DESIRE THE SAME TO BE RECORDED AS SUCH ACCORDING TO LAW.

_____
SIGNATURE OF IDENTIFYING OWNER

IN WITNESS WHEREOF, I HEREUNTO SET MY HAND AND OFFICIAL SEAL.

_____
NOTARY PUBLIC

APPROVALS

HARRISBURG ZONING HEARING BOARD APPROVALS	MAY 18, 2026
DAUPHIN COUNTY PLANNING COMMISSION	
HARRISBURG PLANNING COMMISSION APPROVAL	
HARRISBURG CITY COUNCIL APPROVAL	

LANDOWNER - STORMWATER ACKNOWLEDGEMENT

I, _____, HEREBY ACKNOWLEDGE THAT THE STORMWATER BMPS ARE PERMANENT FIXTURES THAT MAY NOT BE ALTERED OR REMOVED WITHOUT PRIOR APPROVAL BY THE CITY OF HARRISBURG.

ENGINEER OF RECORD - STORMWATER WETLAND CERTIFICATION

I, _____, HEREBY CERTIFY THAT THE STORMWATER MANAGEMENT SITE PLAN MEETS ALL DESIGN STANDARDS AND CRITERIA OF THE CITY OF HARRISBURG'S STORMWATER MANAGMENT ORDINANCE.

I, _____, HEREBY CERTIFY THAT THERE ARE NOT WETLANDS ON THE SUBJECT PROPERTY, THE PROPOSED PROJECT WILL NOT IMPACT OFF-SITE WETLANDS, AND PERMITS ARE NOT REQUIRED FOR THE STATE OR FEDERAL GOVERNMENT.

DRAWING INDEX

SHEET NUMBER	SHEET TITLE
C001	COVER SHEET
C100	GENERAL INFORMATION
C101	EXISTING CONDITIONS AND DEMOLITION PLAN
C102	LOT CONSOLIDATION PLAN
C201	SITE LAYOUT PLAN
C301	PROPOSED GRADING AND STORMWATER PLAN
C401	PROPOSED UTILITIES PLAN
C501	PROFILES
C701	DETAILS
C702	DETAILS
C801	EROSION AND SEDIMENT CONTROL PLAN
C802	EROSION AND SEDIMENT CONTROL DETAILS
C803	EROSION AND SEDIMENT CONTROL NOTES
C901	CAPITAL REGION WATER STANDARD DETAILS
C902	CAPITAL REGION WATER STANDARD DETAILS
C903	CAPITAL REGION WATER STANDARD DETAILS
C904	CAPITAL REGION WATER STANDARD DETAILS

REV	DATE	COMMENTS	BY	CHKD

ISSUE / REVISIONS

LIVIC civil
1015 MUMMA ROAD
2ND FLOOR
WORMLEYSBURG, PA 17043
PHONE: 888.987-1993
www.liviccivil.com

ALL CONTENTS OF THIS PLAN ARE PROPRIETARY AND SHALL NOT BE REPRODUCED OR UTILIZED FOR ANY PURPOSE WITHOUT PRIOR WRITTEN AUTHORIZATION FROM LIVIC CIVIL, LLC. ONLY APPROVED, SEALED PLANS SHALL BE IMPLEMENTED FOR CONSTRUCTION PURPOSES.
© 2026 LIVIC CIVIL, LLC


PROJECT No:	1437-01
DATE:	JUNE 1, 2026
SCALE:	AS SHOWN
DRAWN BY: MSI	CHECKED BY: DRG

PROJECT
1257-1259 WALNUT STREET
CITY OF HARRISBURG
DAUPHIN COUNTY
PENNSYLVANIA

CLIENT
BIG US WORKBASE TRAINING, INC.
1952 MANADA STREET
HARRISBURG, PA 17104
PHONE: (717) 379-3481

SHEET TITLE
COVER SHEET

SHEET NO.
C001

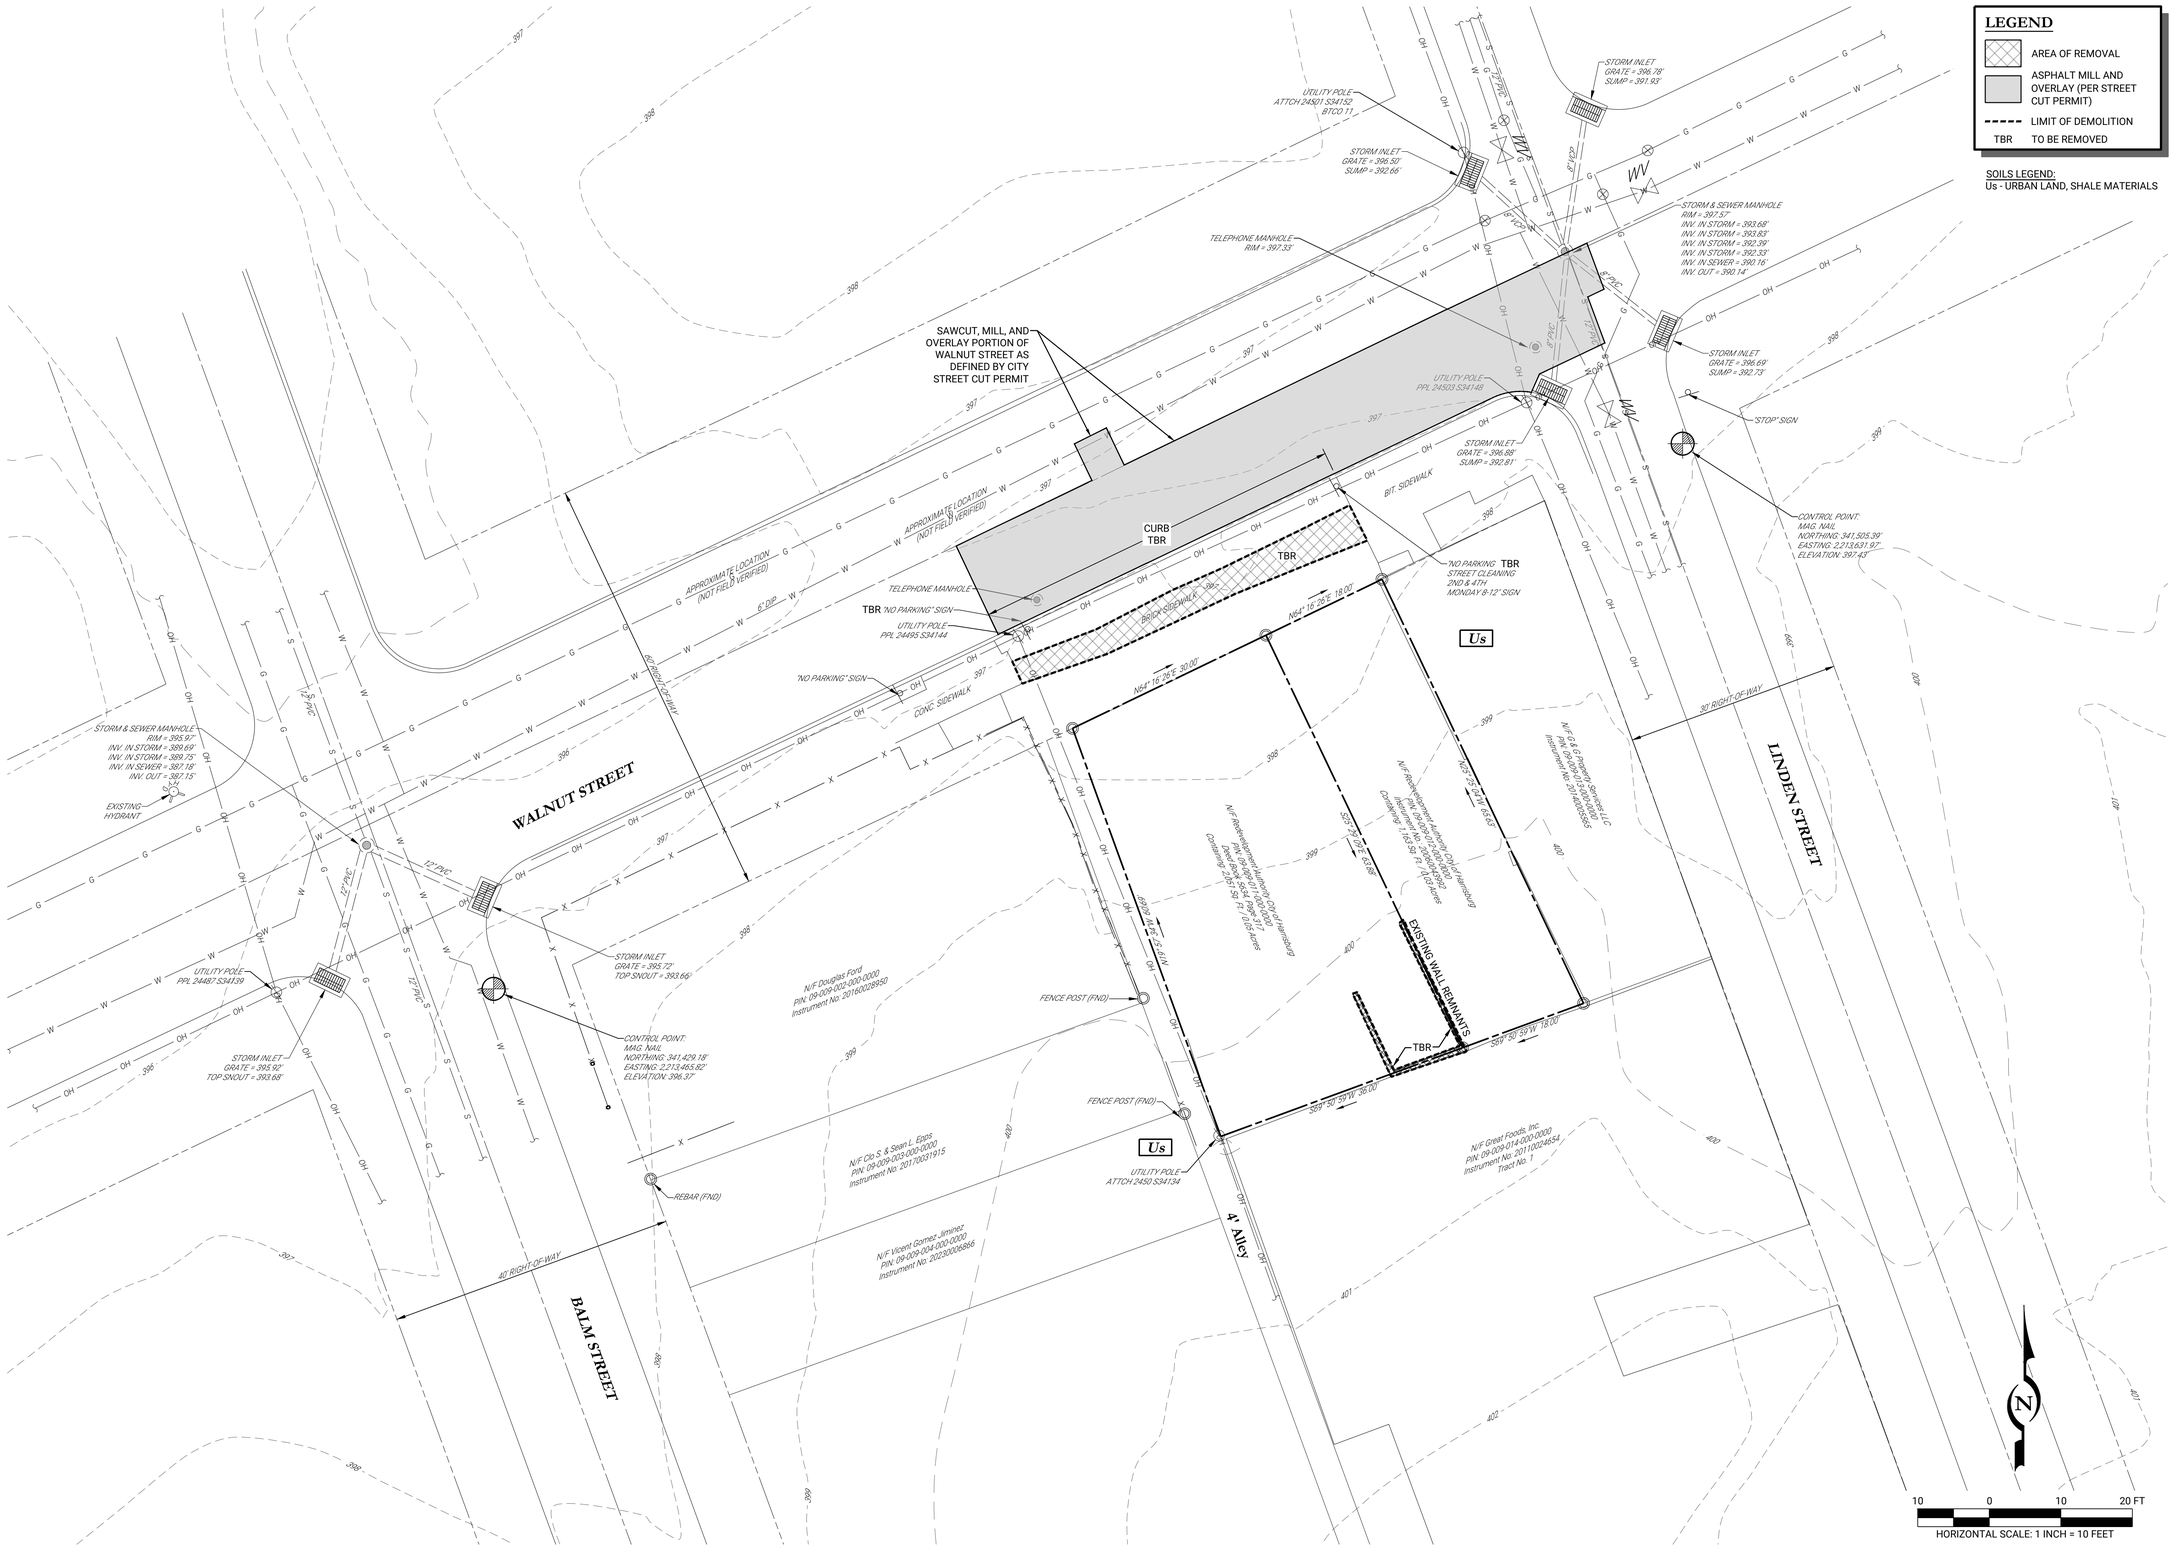

REV	DATE	COMMENTS / ISSUE / REVISIONS	BY	CHKD

LIVIC civil
1015 MUMMA ROAD
2ND FLOOR
WORMLEYSBURG, PA 17043
PHONE: 888.987-1993
www.liviccivil.com

ALL CONTENTS OF THIS PLAN ARE PROPRIETARY AND SHALL NOT BE REPRODUCED OR UTILIZED FOR ANY PURPOSE WITHOUT PRIOR WRITTEN AUTHORIZATION FROM LIVIC CIVIL, LLC. ONLY APPROVED, SEALED PLANS SHALL BE IMPLEMENTED FOR CONSTRUCTION PURPOSES.
© 2026 LIVIC CIVIL, LLC

PROJECT No:	1437-01
DATE:	JUNE 1, 2026
SCALE:	AS SHOWN
DRAWN BY: MSI	CHECKED BY: DRG

PROJECT

1257-1259 WALNUT STREET

CITY OF HARRISBURG

DAUPHIN COUNTY

PENNSYLVANIA

CLIENT

BIG US WORKBASE TRAINING, INC.


1952 MANADA STREET
HARRISBURG, PA 17104
PHONE: (717) 379-3481

SHEET TITLE

EXISTING CONDITIONS AND DEMOLITION PLAN

SHEET NO.

C101

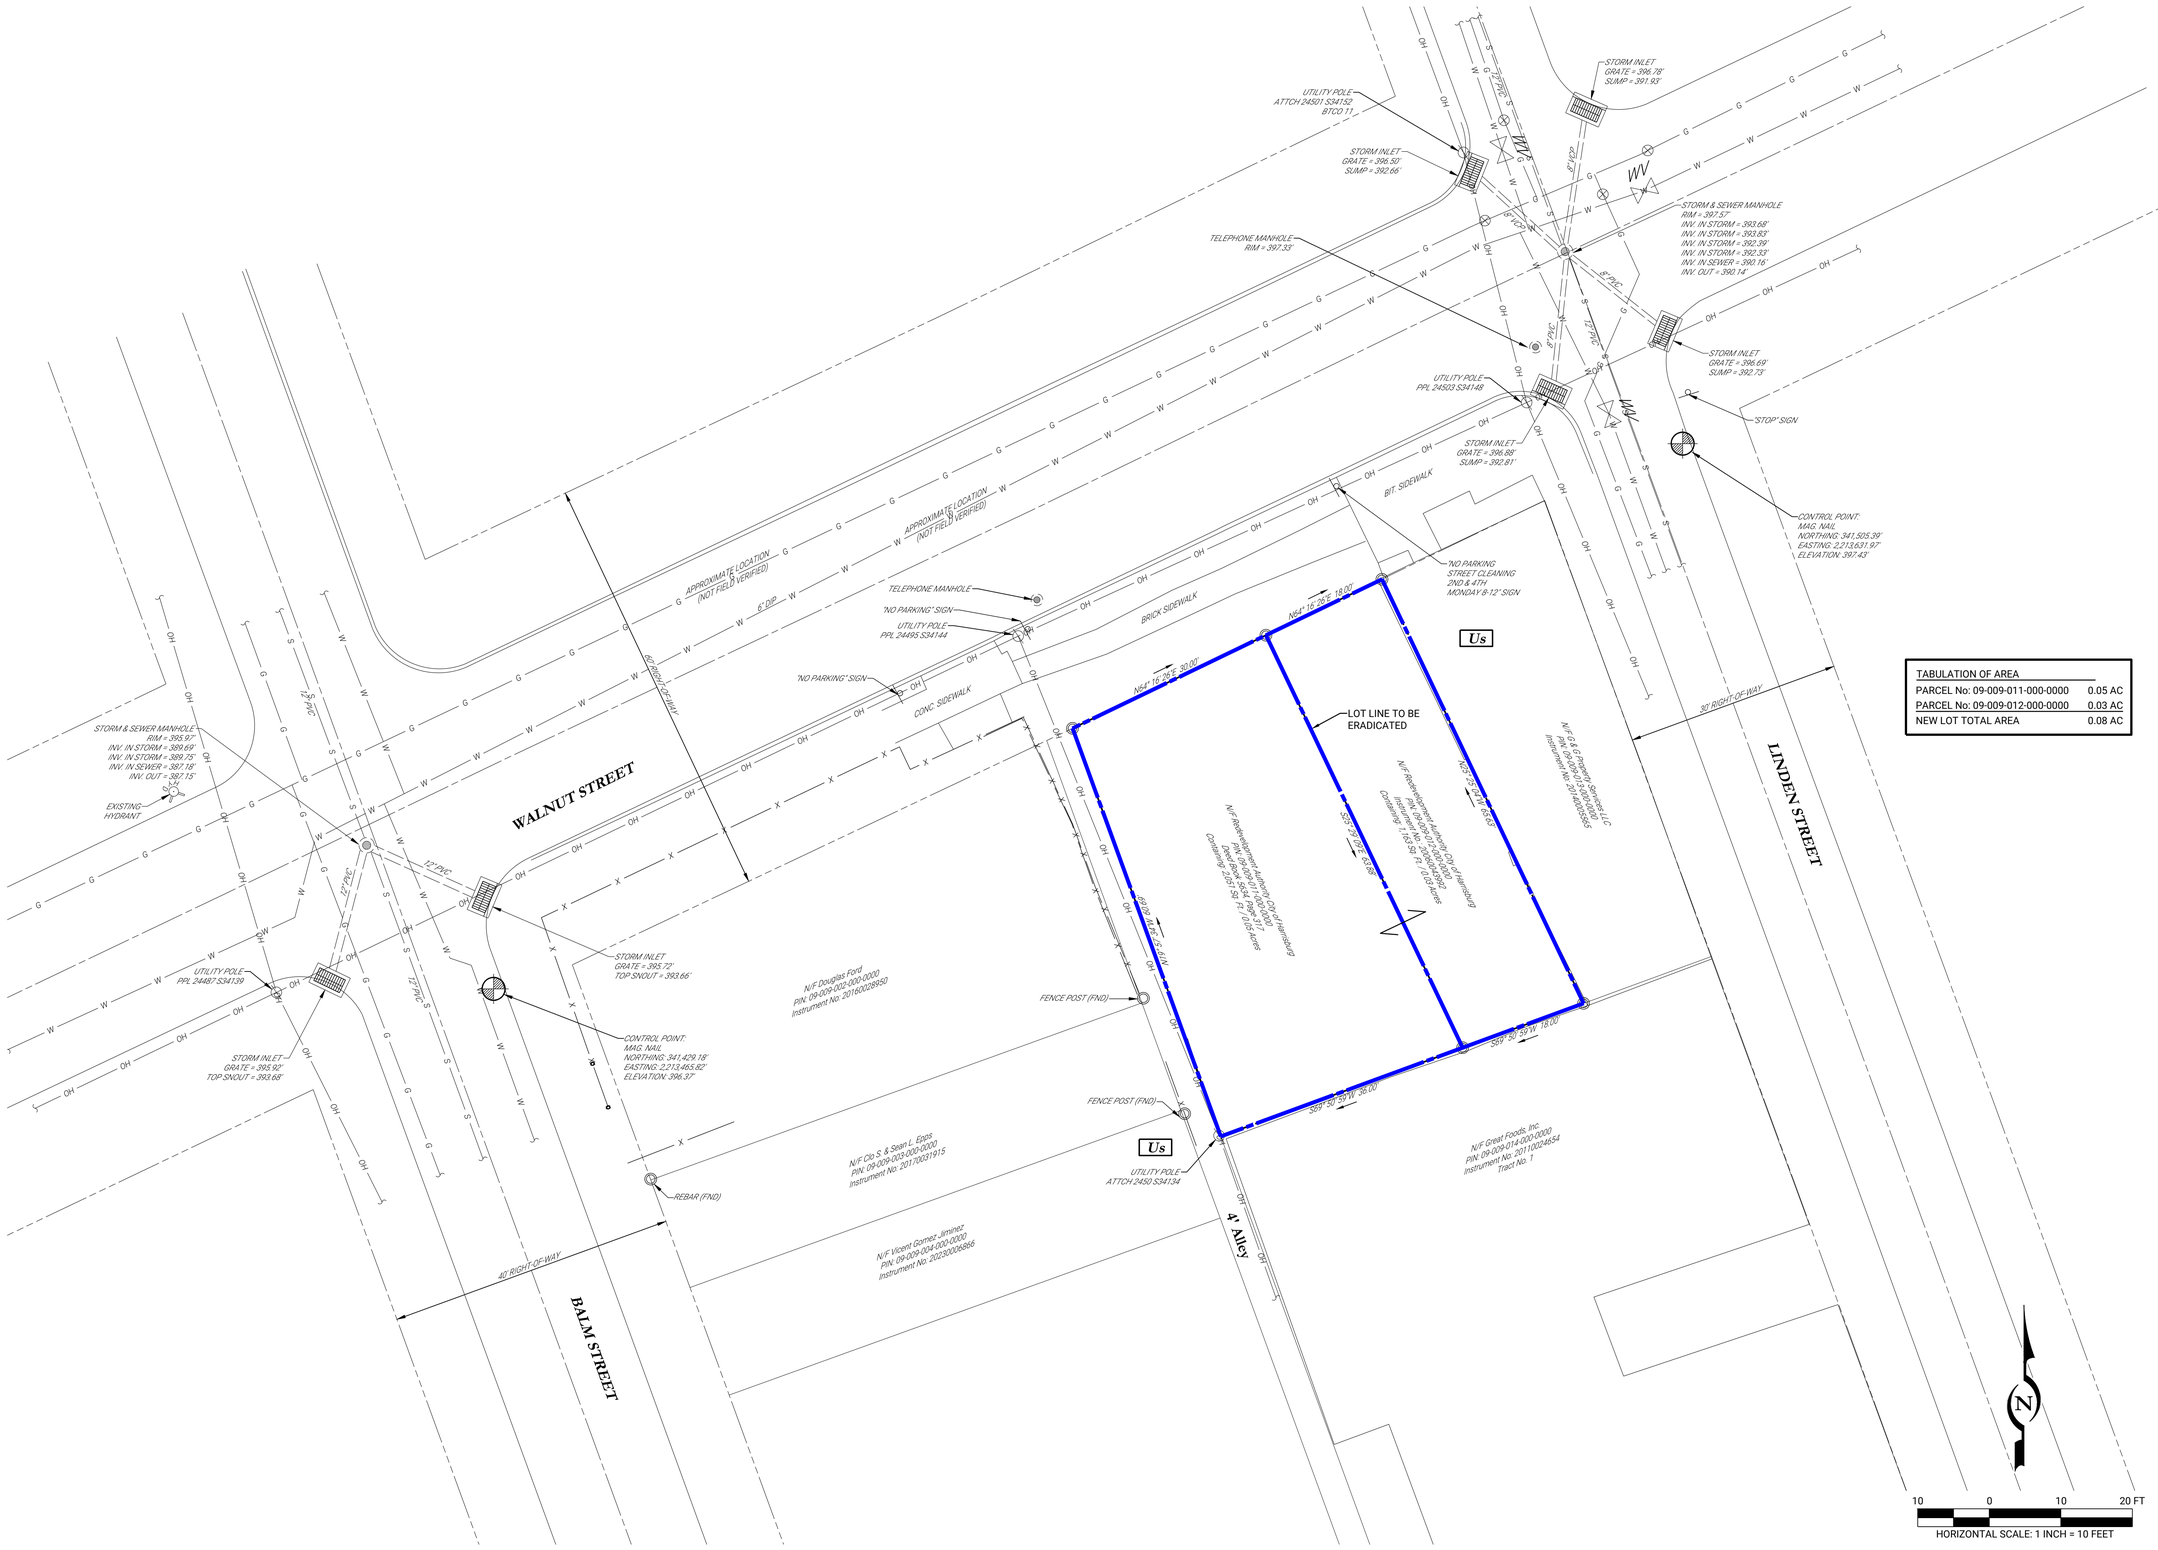

TABULATION OF AREA	
PARCEL No: 09-009-011-000-0000	0.05 AC
PARCEL No: 09-009-012-000-0000	0.03 AC
NEW LOT TOTAL AREA	0.08 AC

REV	DATE	ISSUE / REVISIONS	BY	CHKD
		COMMENTS		

LIVIC civil
1015 MUMMA ROAD
2ND FLOOR
WORMLEYSBURG, PA 17043
PHONE: 888.987-1993
www.liviccivil.com

ALL CONTENTS OF THIS PLAN ARE PROPRIETARY AND SHALL NOT BE REPRODUCED OR UTILIZED FOR ANY PURPOSE WITHOUT PRIOR WRITTEN AUTHORIZATION FROM LIVIC CIVIL, LLC. ONLY APPROVED, SEALED PLANS SHALL BE IMPLEMENTED FOR CONSTRUCTION PURPOSES.
© 2026 LIVIC CIVIL, LLC

PROJECT No:	1437-01
DATE:	JUNE 1, 2026
SCALE:	AS SHOWN
DRAWN BY: MSI	CHECKED BY: DRG

PROJECT

1257-1259 WALNUT STREET

CITY OF HARRISBURG

DAUPHIN COUNTY

PENNSYLVANIA

CLIENT

BIG US WORKBASE TRAINING, INC.


1952 MANADA STREET
HARRISBURG, PA 17104
PHONE: (717) 379-3481

SHEET TITLE

LOT CONSOLIDATION PLAN

SHEET NO.

C102

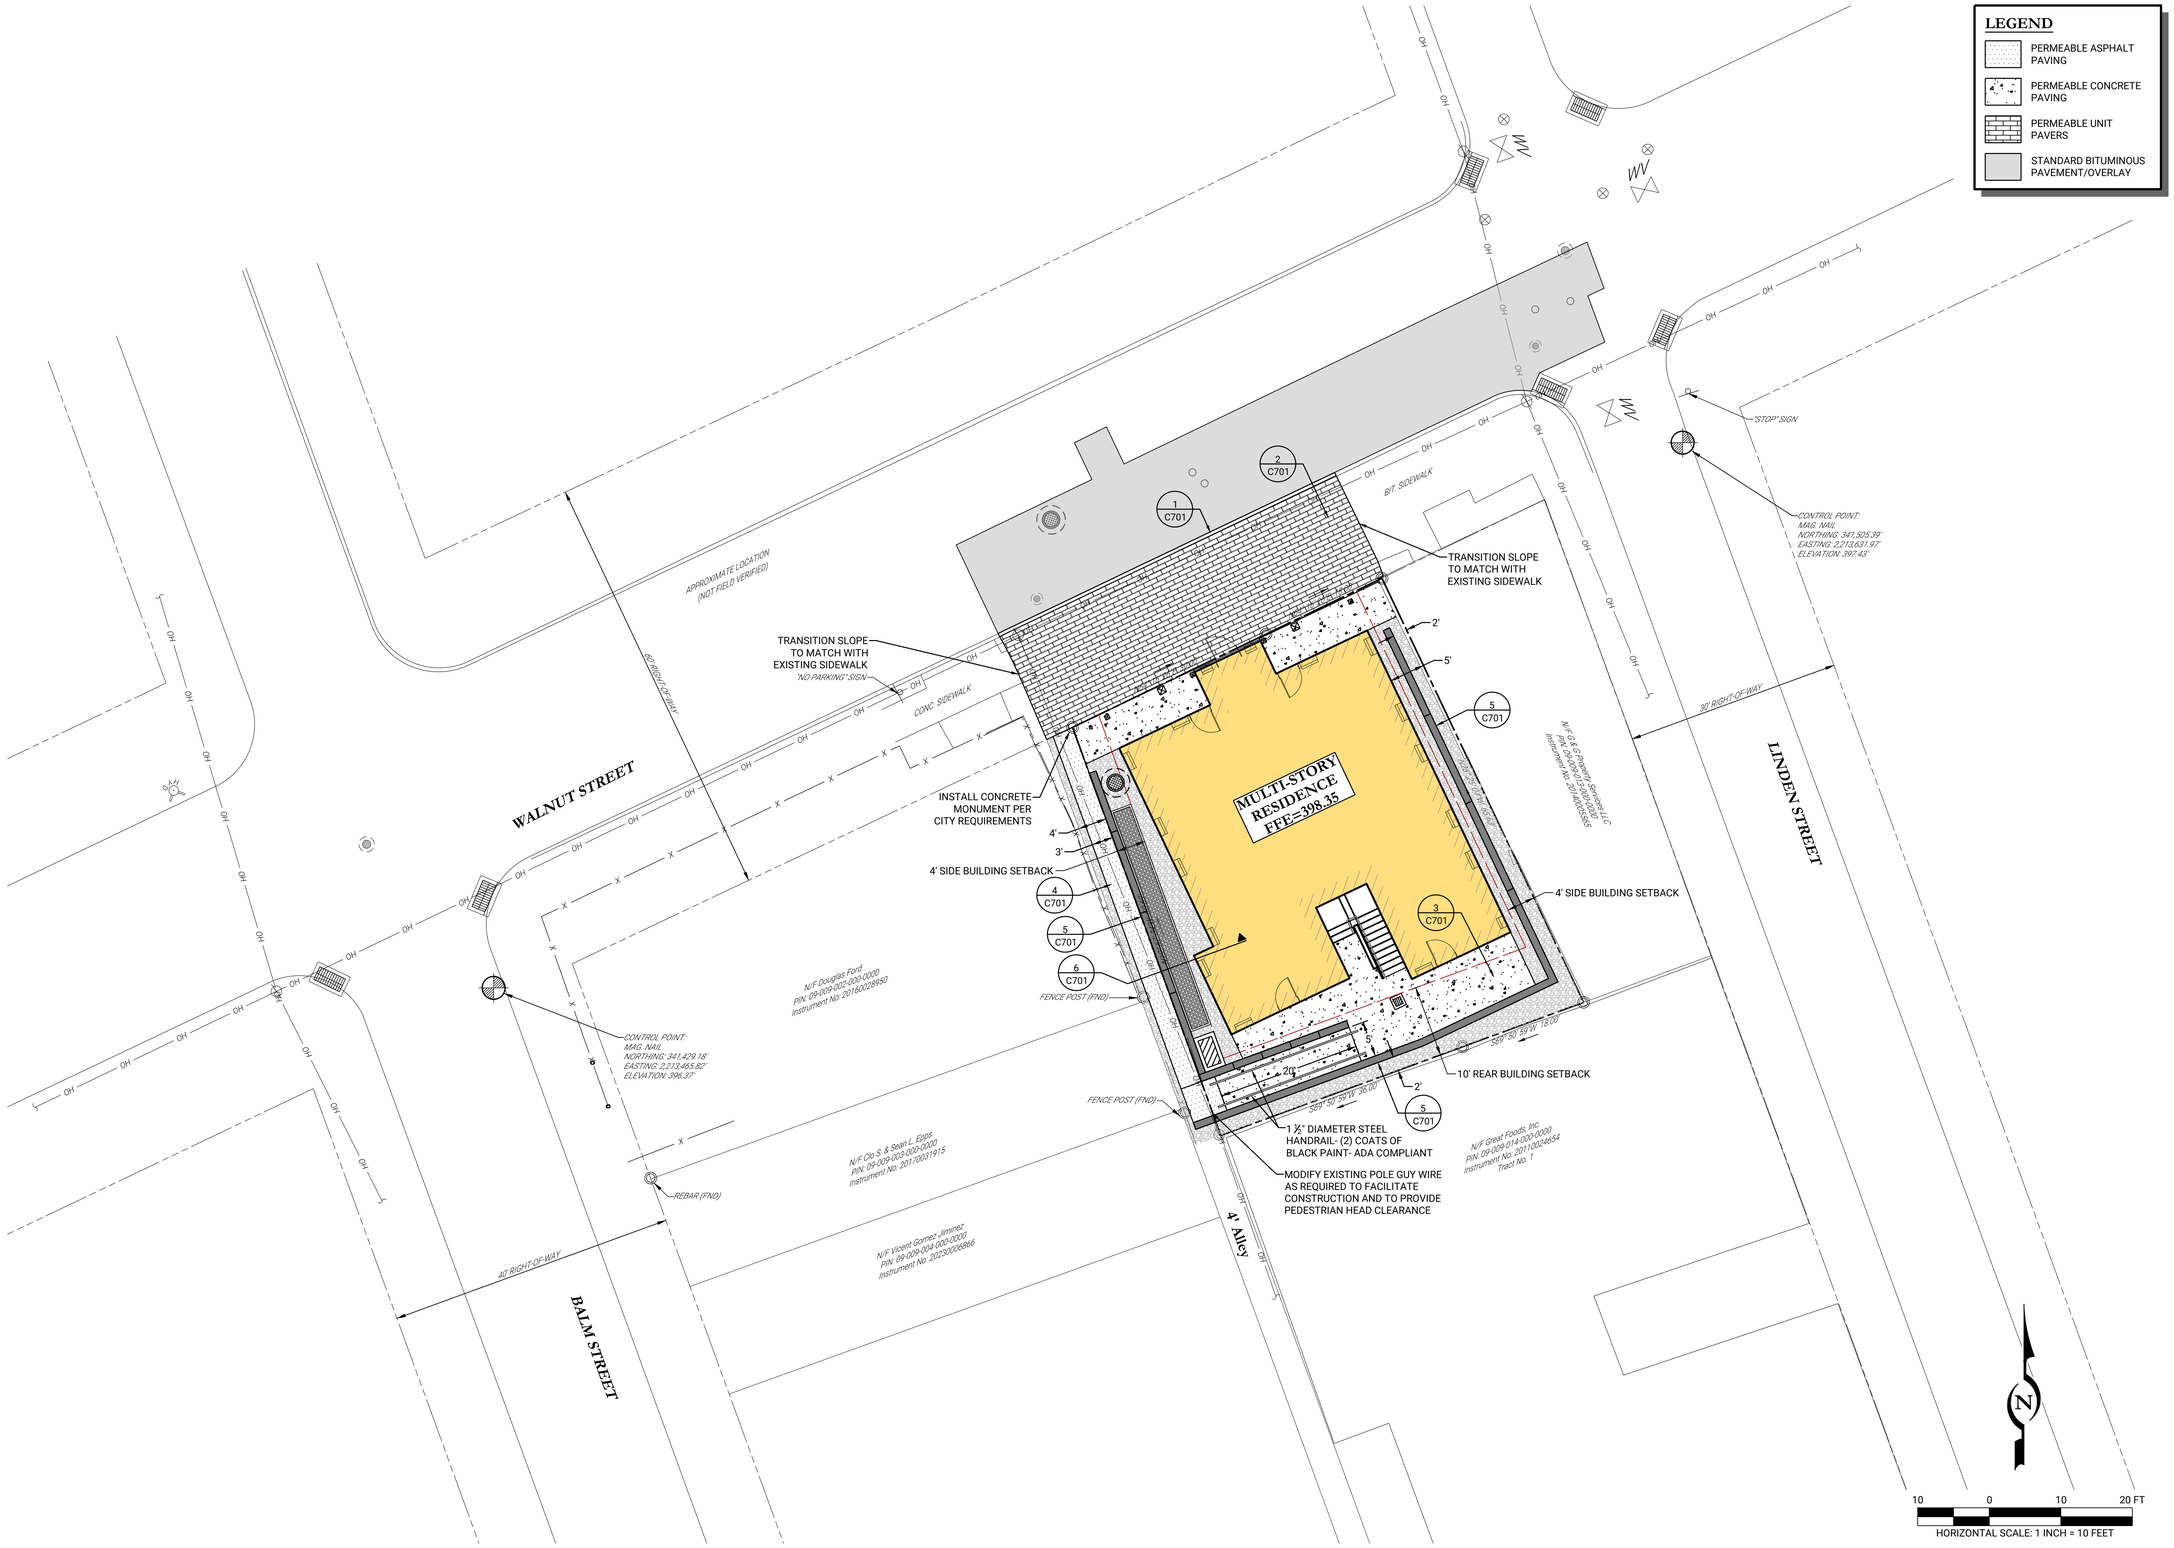

REV	DATE	COMMENTS	BY	CHKD

ISSUE / REVISIONS

LIVIC civil
1015 MUMMA ROAD
2ND FLOOR
WORMLEYSBURG, PA 17043
PHONE: 888.987-1993
www.liviccivil.com

ALL CONTENTS OF THIS PLAN ARE PROPRIETARY AND SHALL NOT BE REPRODUCED OR UTILIZED FOR ANY PURPOSE WITHOUT PRIOR WRITTEN AUTHORIZATION FROM LIVIC CIVIL, LLC. ONLY APPROVED, SEALED PLANS SHALL BE IMPLEMENTED FOR CONSTRUCTION PURPOSES.
© 2026 LIVIC CIVIL, LLC

PROJECT No:	1437-01
DATE:	JUNE 1, 2026
SCALE:	AS SHOWN
DRAWN BY: MSI	CHECKED BY: DRG

PROJECT

1257-1259 WALNUT STREET

CITY OF HARRISBURG

DAUPHIN COUNTY

PENNSYLVANIA

CLIENT

BIG US WORKBASE TRAINING, INC.


1952 MANADA STREET
HARRISBURG, PA 17104
PHONE: (717) 379-3481

SHEET TITLE

SITE LAYOUT PLAN

SHEET NO.

C201

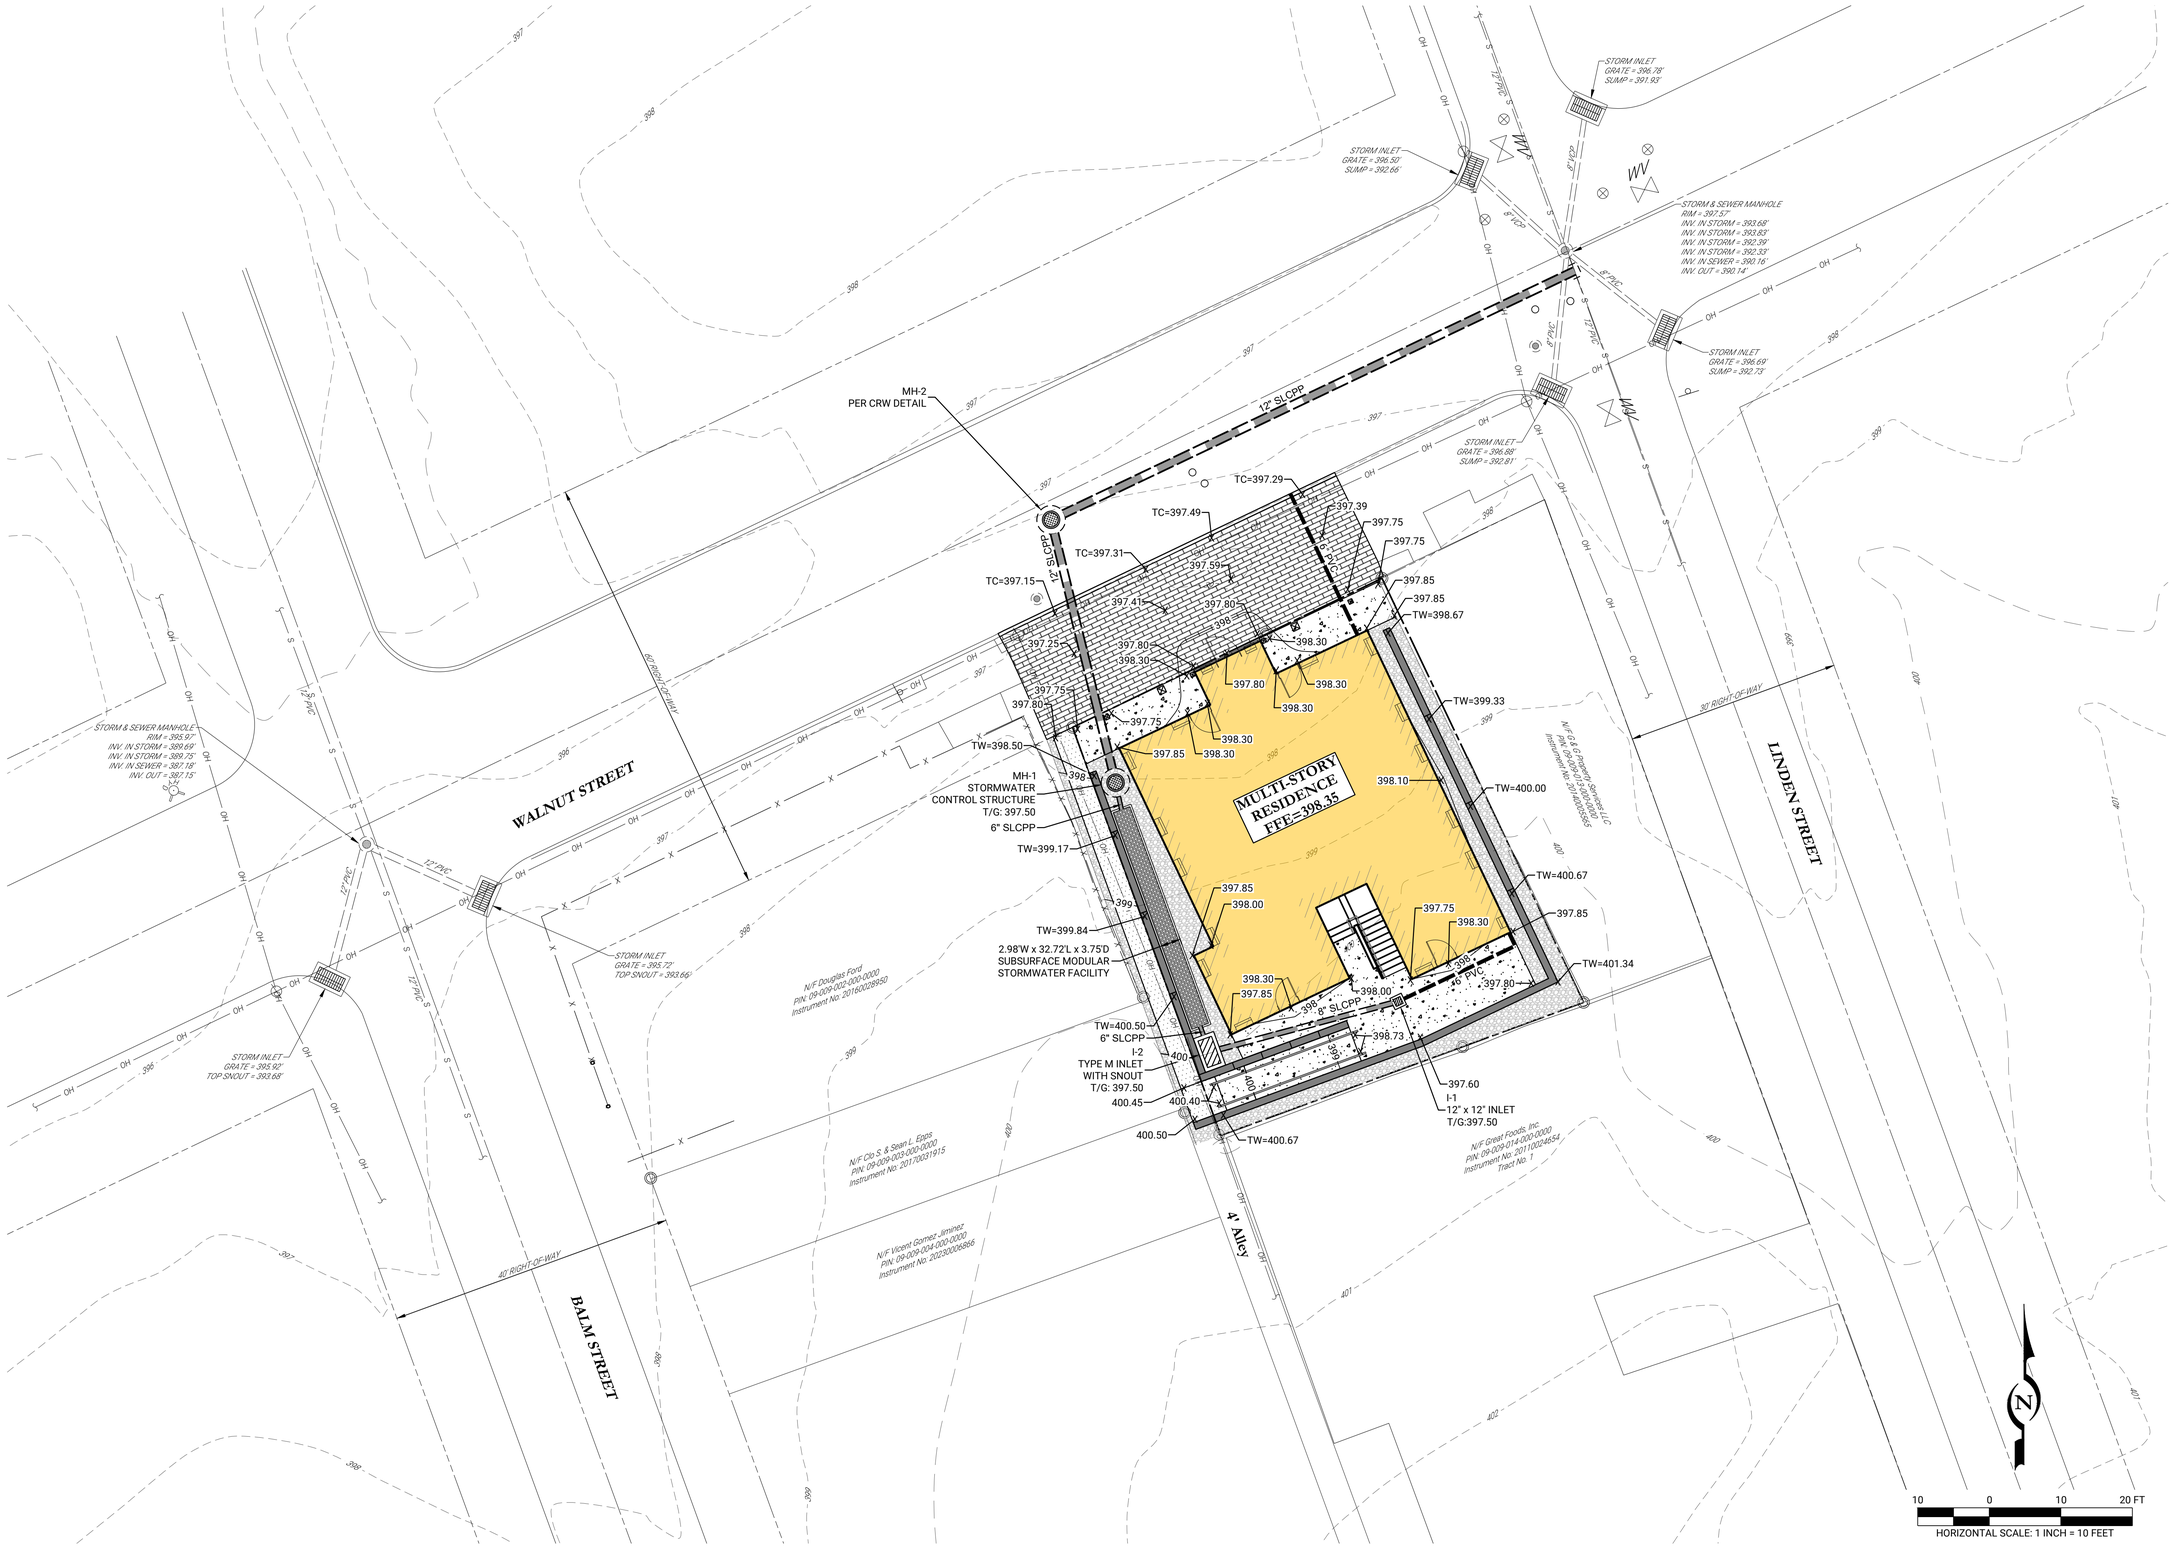

REV	DATE	COMMENTS / ISSUE / REVISIONS	BY	CHKD

LIVIC civil
1015 MUMMA ROAD
2ND FLOOR
WORMLEYSBURG, PA 17043
PHONE: 888.987-1993
www.liviccivil.com

ALL CONTENTS OF THIS PLAN ARE PROPRIETARY AND SHALL NOT BE REPRODUCED OR UTILIZED FOR ANY PURPOSE WITHOUT PRIOR WRITTEN AUTHORIZATION FROM LIVIC CIVIL, LLC. ONLY APPROVED, SEALED PLANS SHALL BE IMPLEMENTED FOR CONSTRUCTION PURPOSES.
© 2026 LIVIC CIVIL, LLC

PROJECT No:	1437-01
DATE:	JUNE 1, 2026
SCALE:	AS SHOWN
DRAWN BY: MSI	CHECKED BY: DRG

PROJECT

1257-1259 WALNUT STREET

CITY OF HARRISBURG

DAUPHIN COUNTY

PENNSYLVANIA

CLIENT

BIG US WORKBASE TRAINING, INC.


1952 MANADA STREET
HARRISBURG, PA 17104
PHONE: (717) 379-3481

SHEET TITLE

PROPOSED GRADING AND STORMWATER PLAN

SHEET NO.

C301

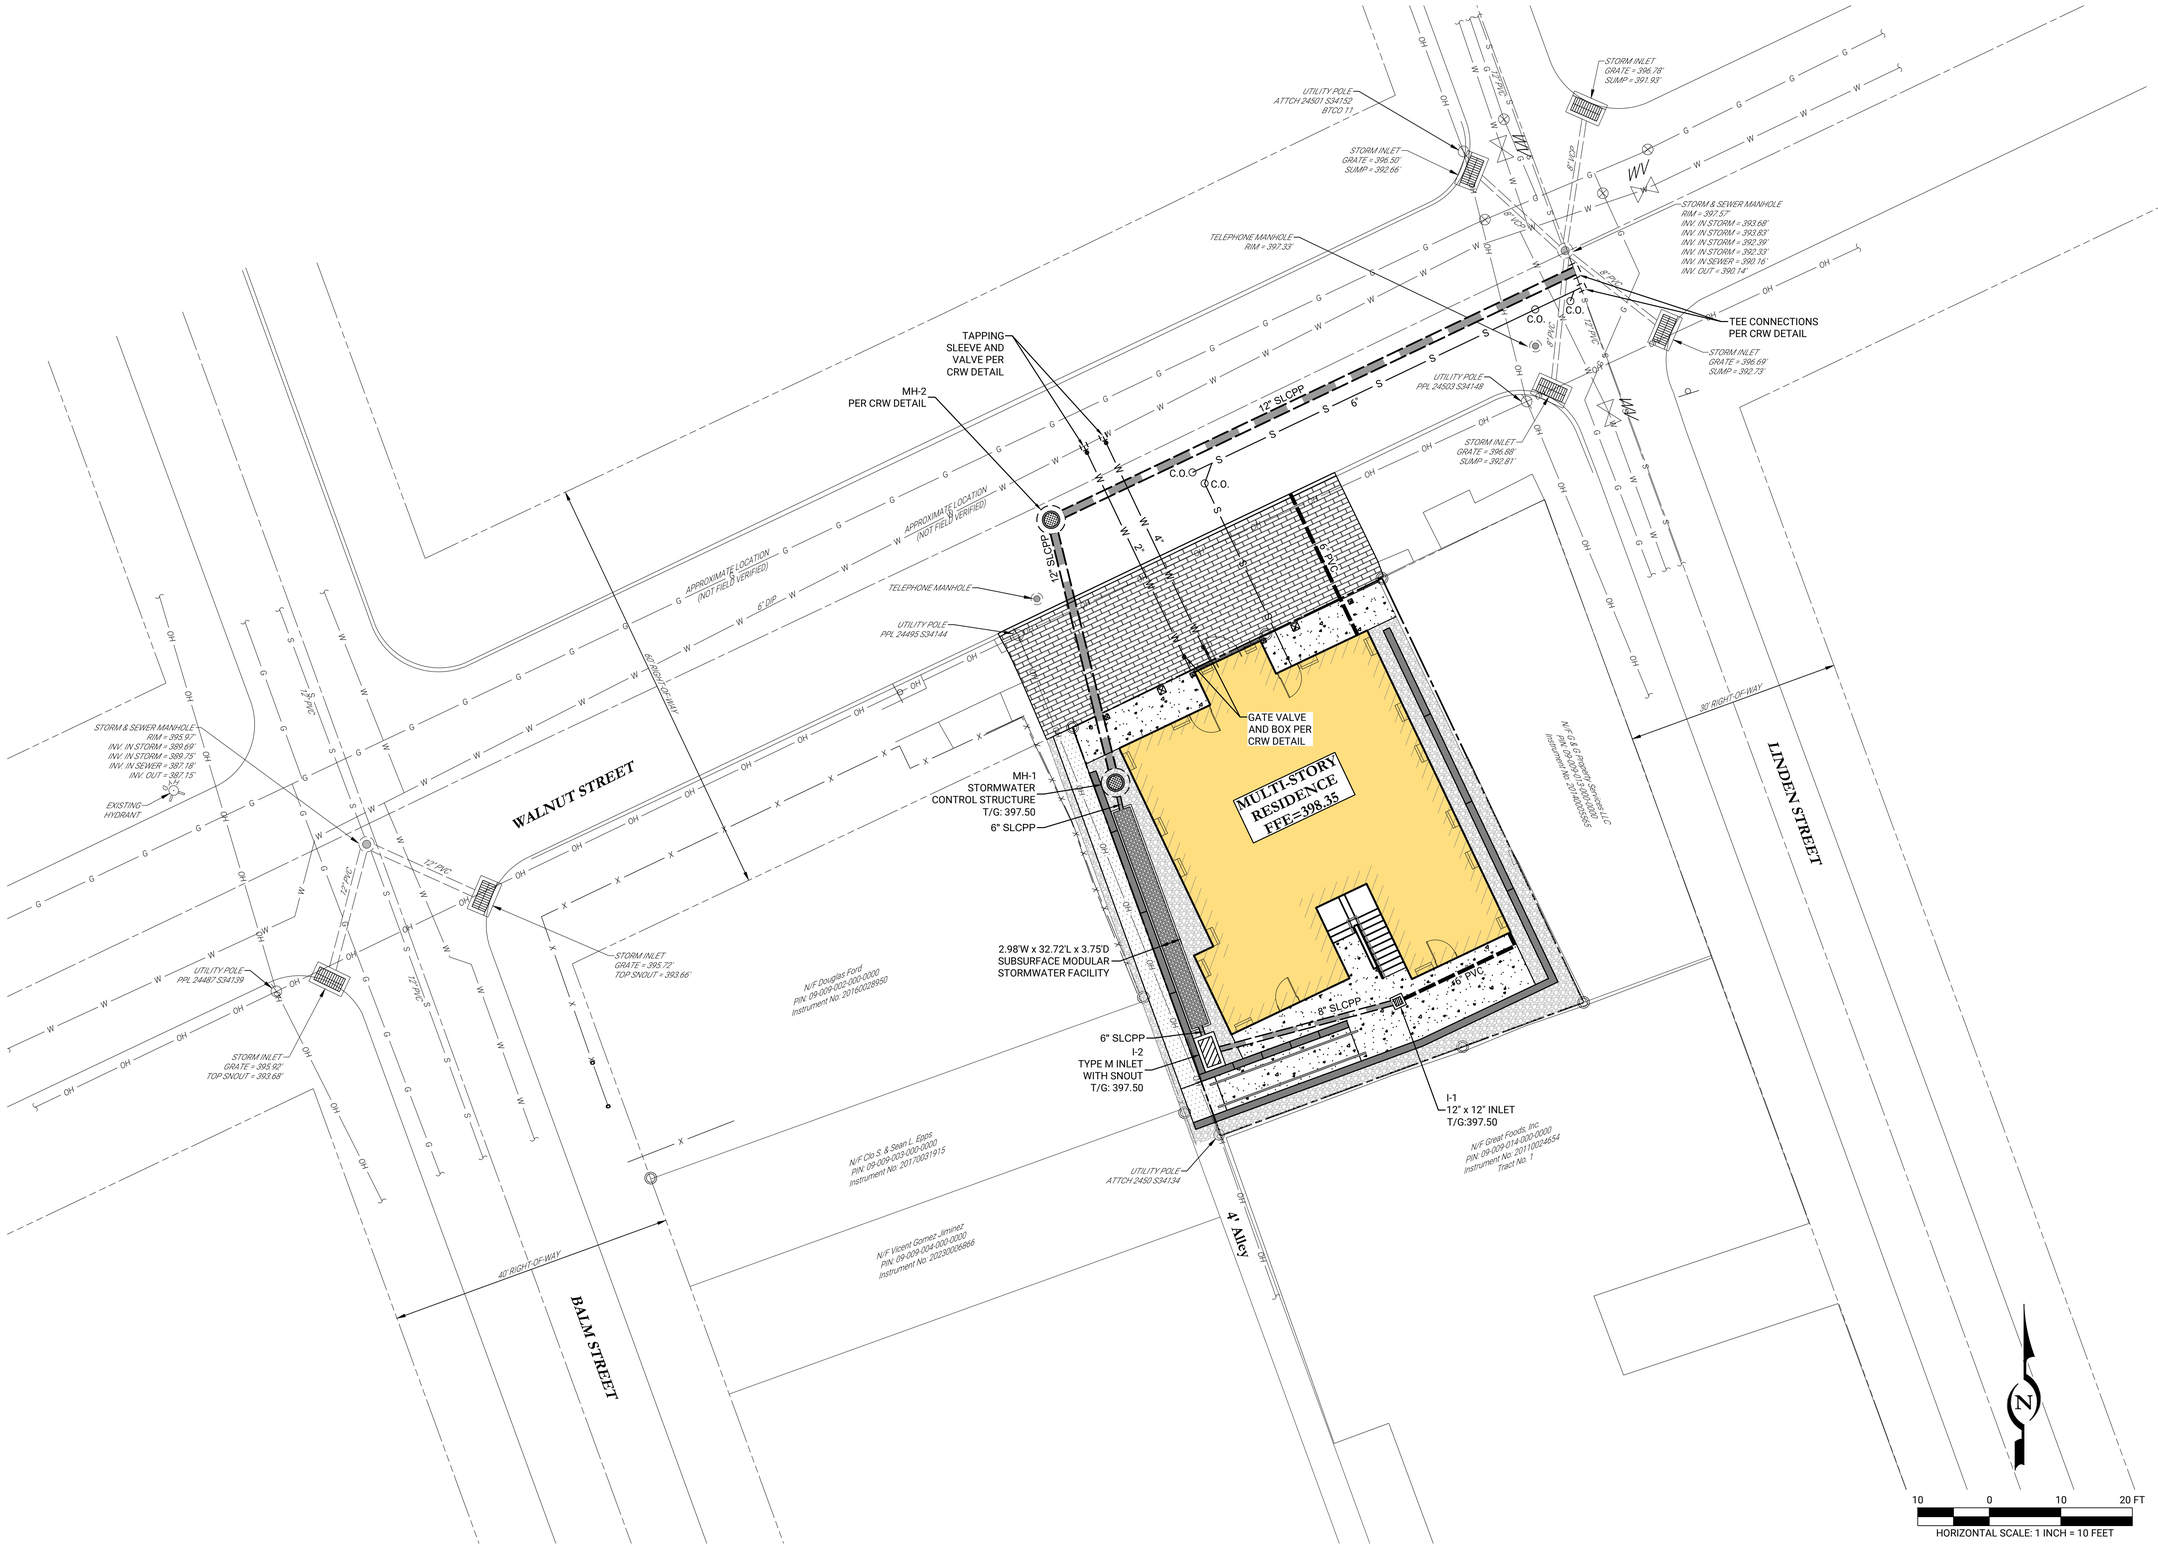

REV	DATE	COMMENTS / ISSUE / REVISIONS	BY	CHKD

LIVIC civil
1015 MUMMA ROAD
2ND FLOOR
WORMLEYSBURG, PA 17043
PHONE: 888.987-1993
www.liviccivil.com

ALL CONTENTS OF THIS PLAN ARE PROPRIETARY AND SHALL NOT BE REPRODUCED OR UTILIZED FOR ANY PURPOSE WITHOUT PRIOR WRITTEN AUTHORIZATION FROM LIVIC CIVIL, LLC. ONLY APPROVED, SEALED PLANS SHALL BE IMPLEMENTED FOR CONSTRUCTION PURPOSES.
© 2026 LIVIC CIVIL, LLC

PROJECT No:	1437-01
DATE:	JUNE 1, 2026
SCALE:	AS SHOWN
DRAWN BY: MSI	CHECKED BY: DRG

PROJECT

1257-1259 WALNUT STREET

CITY OF HARRISBURG

DAUPHIN COUNTY

PENNSYLVANIA

CLIENT

BIG US WORKBASE TRAINING, INC.

1952 MANADA STREET
HARRISBURG, PA 17104
PHONE: (717) 379-3481

SHEET TITLE

PROPOSED UTILITIES PLAN

SHEET NO.

C401